
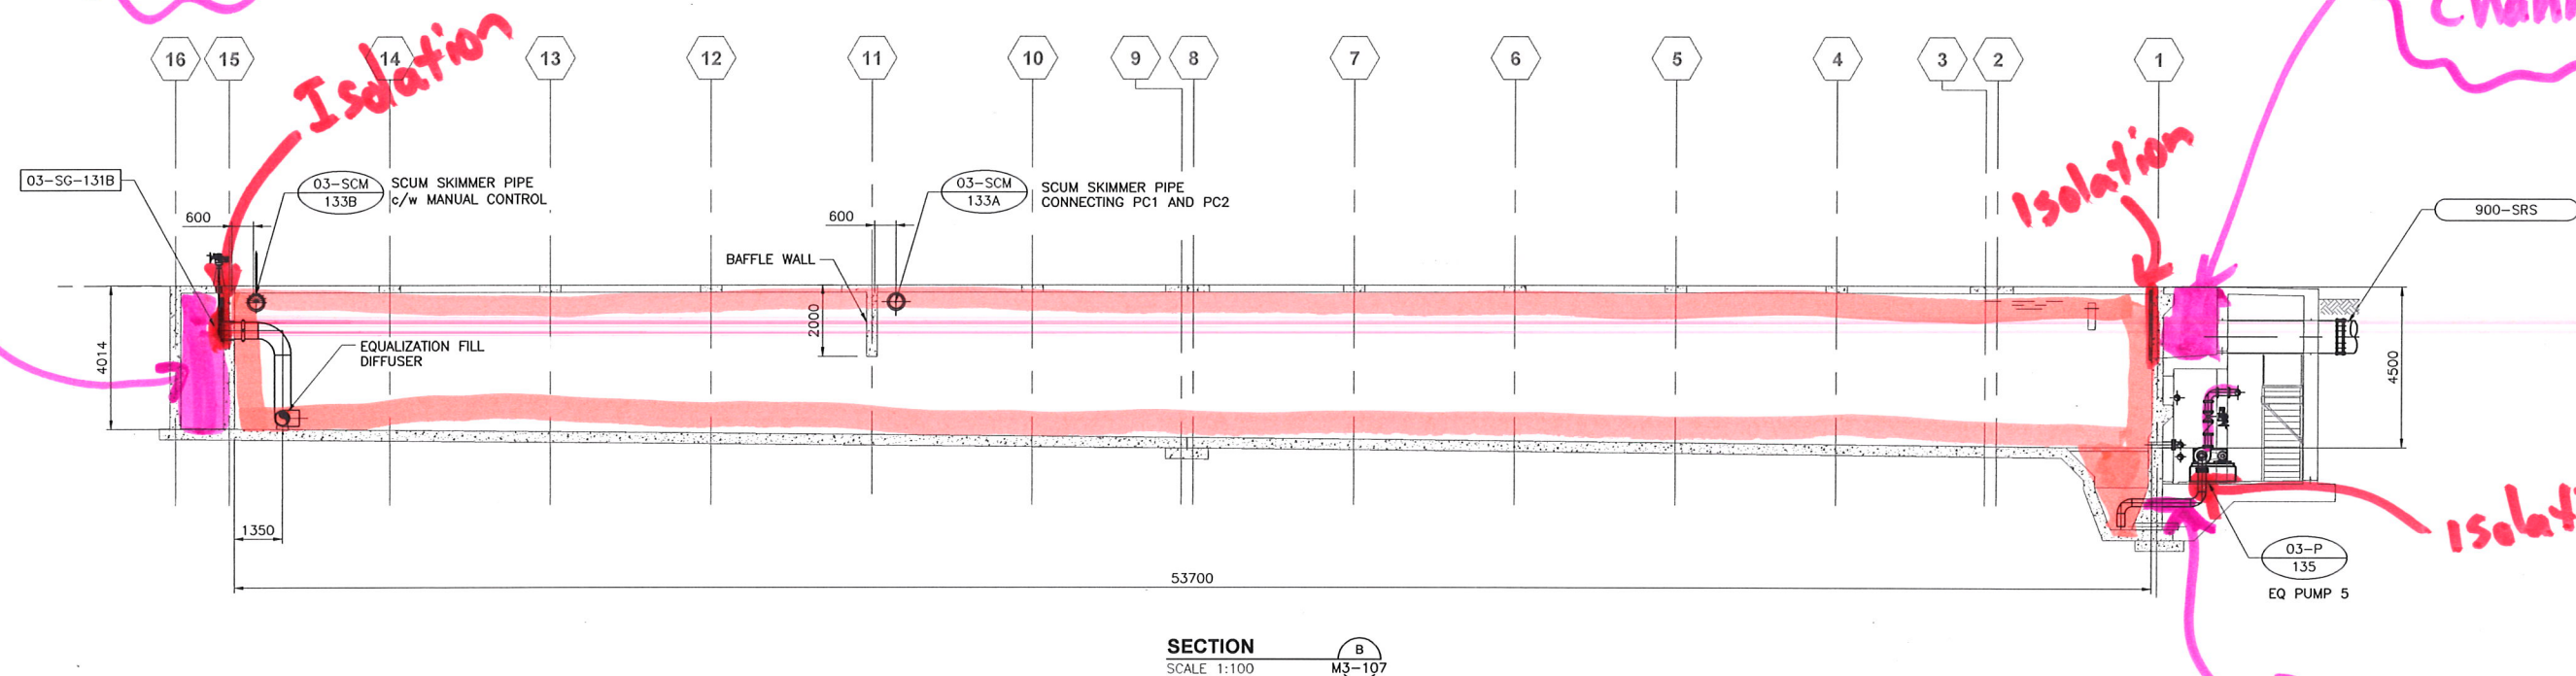


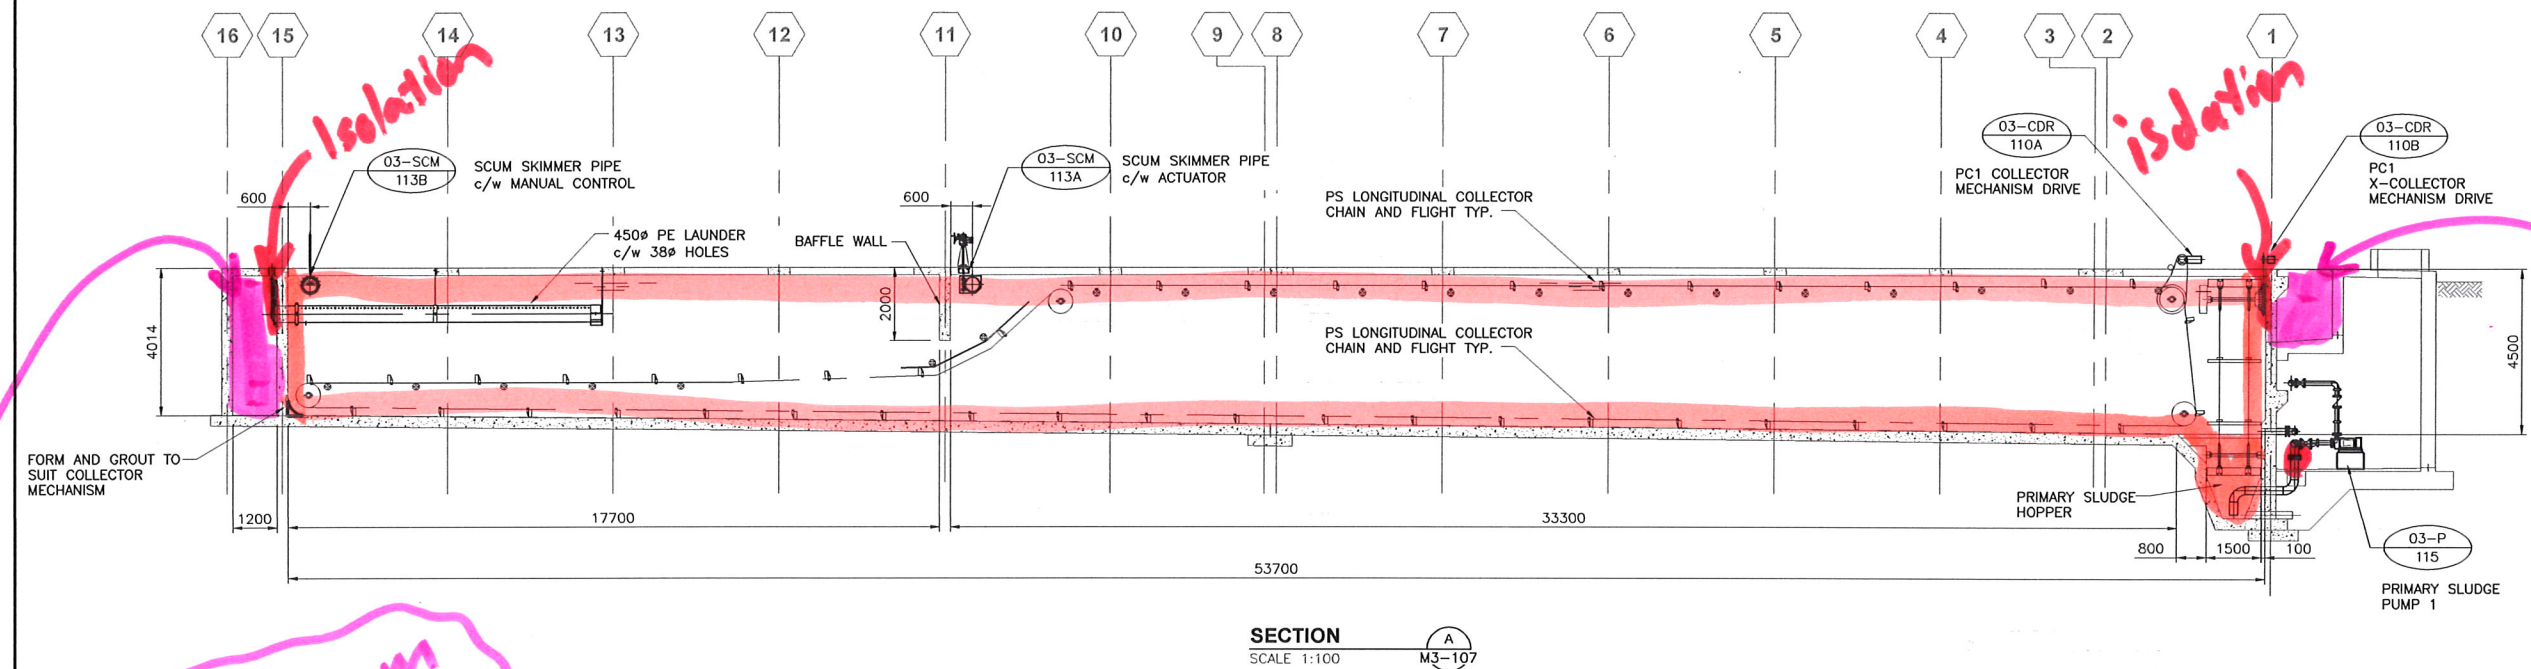


isolation

 Tanks

NOTICE:
AS-CONSTRUCTED DIMENSIONS, MEASUREMENTS AND
OTHER DETAILS CONTAINED IN THIS RECORD DRAWING
HAVE BEEN OBTAINED BY AECOM CANADA LTD.
("AECOM") FROM VARIOUS SOURCES. SUCH
INFORMATION REPRESENTS THE BEST INFORMATION
AVAILABLE TO AECOM AT THE TIME OF PREPARATION
OF THIS RECORD DRAWING. AECOM DOES NOT IN ANY
WAY REPRESENT OR WARRANT THAT SUCH
INFORMATION IS ACCURATE AND ASSUMES NO
RESPONSIBILITY FOR ANY ERRORS OR OMISSIONS
CONTAINED THEREIN.


CITY OF PENTICTON AWWTP UPGRADE PENTICTON, B.C. PROCESS MECHANICAL PRIMARY CLARIFIERS AND EQUALIZATION SECTIONS AND DETAILS	PROJECT START DATE (M/Y) APRIL 2008	PREPARED BY: AECOM Suite 201, 3275 LAKESHORE ROAD, KELOWNA, BC, CANADA V1W 3S9 250-762-3727  PREPARED FOR:	DRN BY: KJW				
	PROJECT NO. 102949		DES BY: PG	3	RECORD DRAWING	CJM	2013/08/09
	FILENAME M3-109.dwg		CHK BY: LN	2	REVISED PUMP ARRANGEMENT	KJW	2010/02/26
	SHEET NO.		APP BY: 0	1	ISSUED FOR CONSTRUCTION	PTL	2009/08/31
				0	ISSUED FOR TENDER	KJW	2009/05/25
DRAWING NO. M3-109		REV	DESCRIPTION	REAL	CHK	DATE (M/Y)	

Plotted By: millercj
Plot File Date Created: Aug/08/2013 10:59 AM
Layout-Sheet Name: M3-106
Filename: L:\WORK\102949\02A-CAD\WAT\DETAIL DESIGN\6-PROCESS MECH\M3-106.DWG

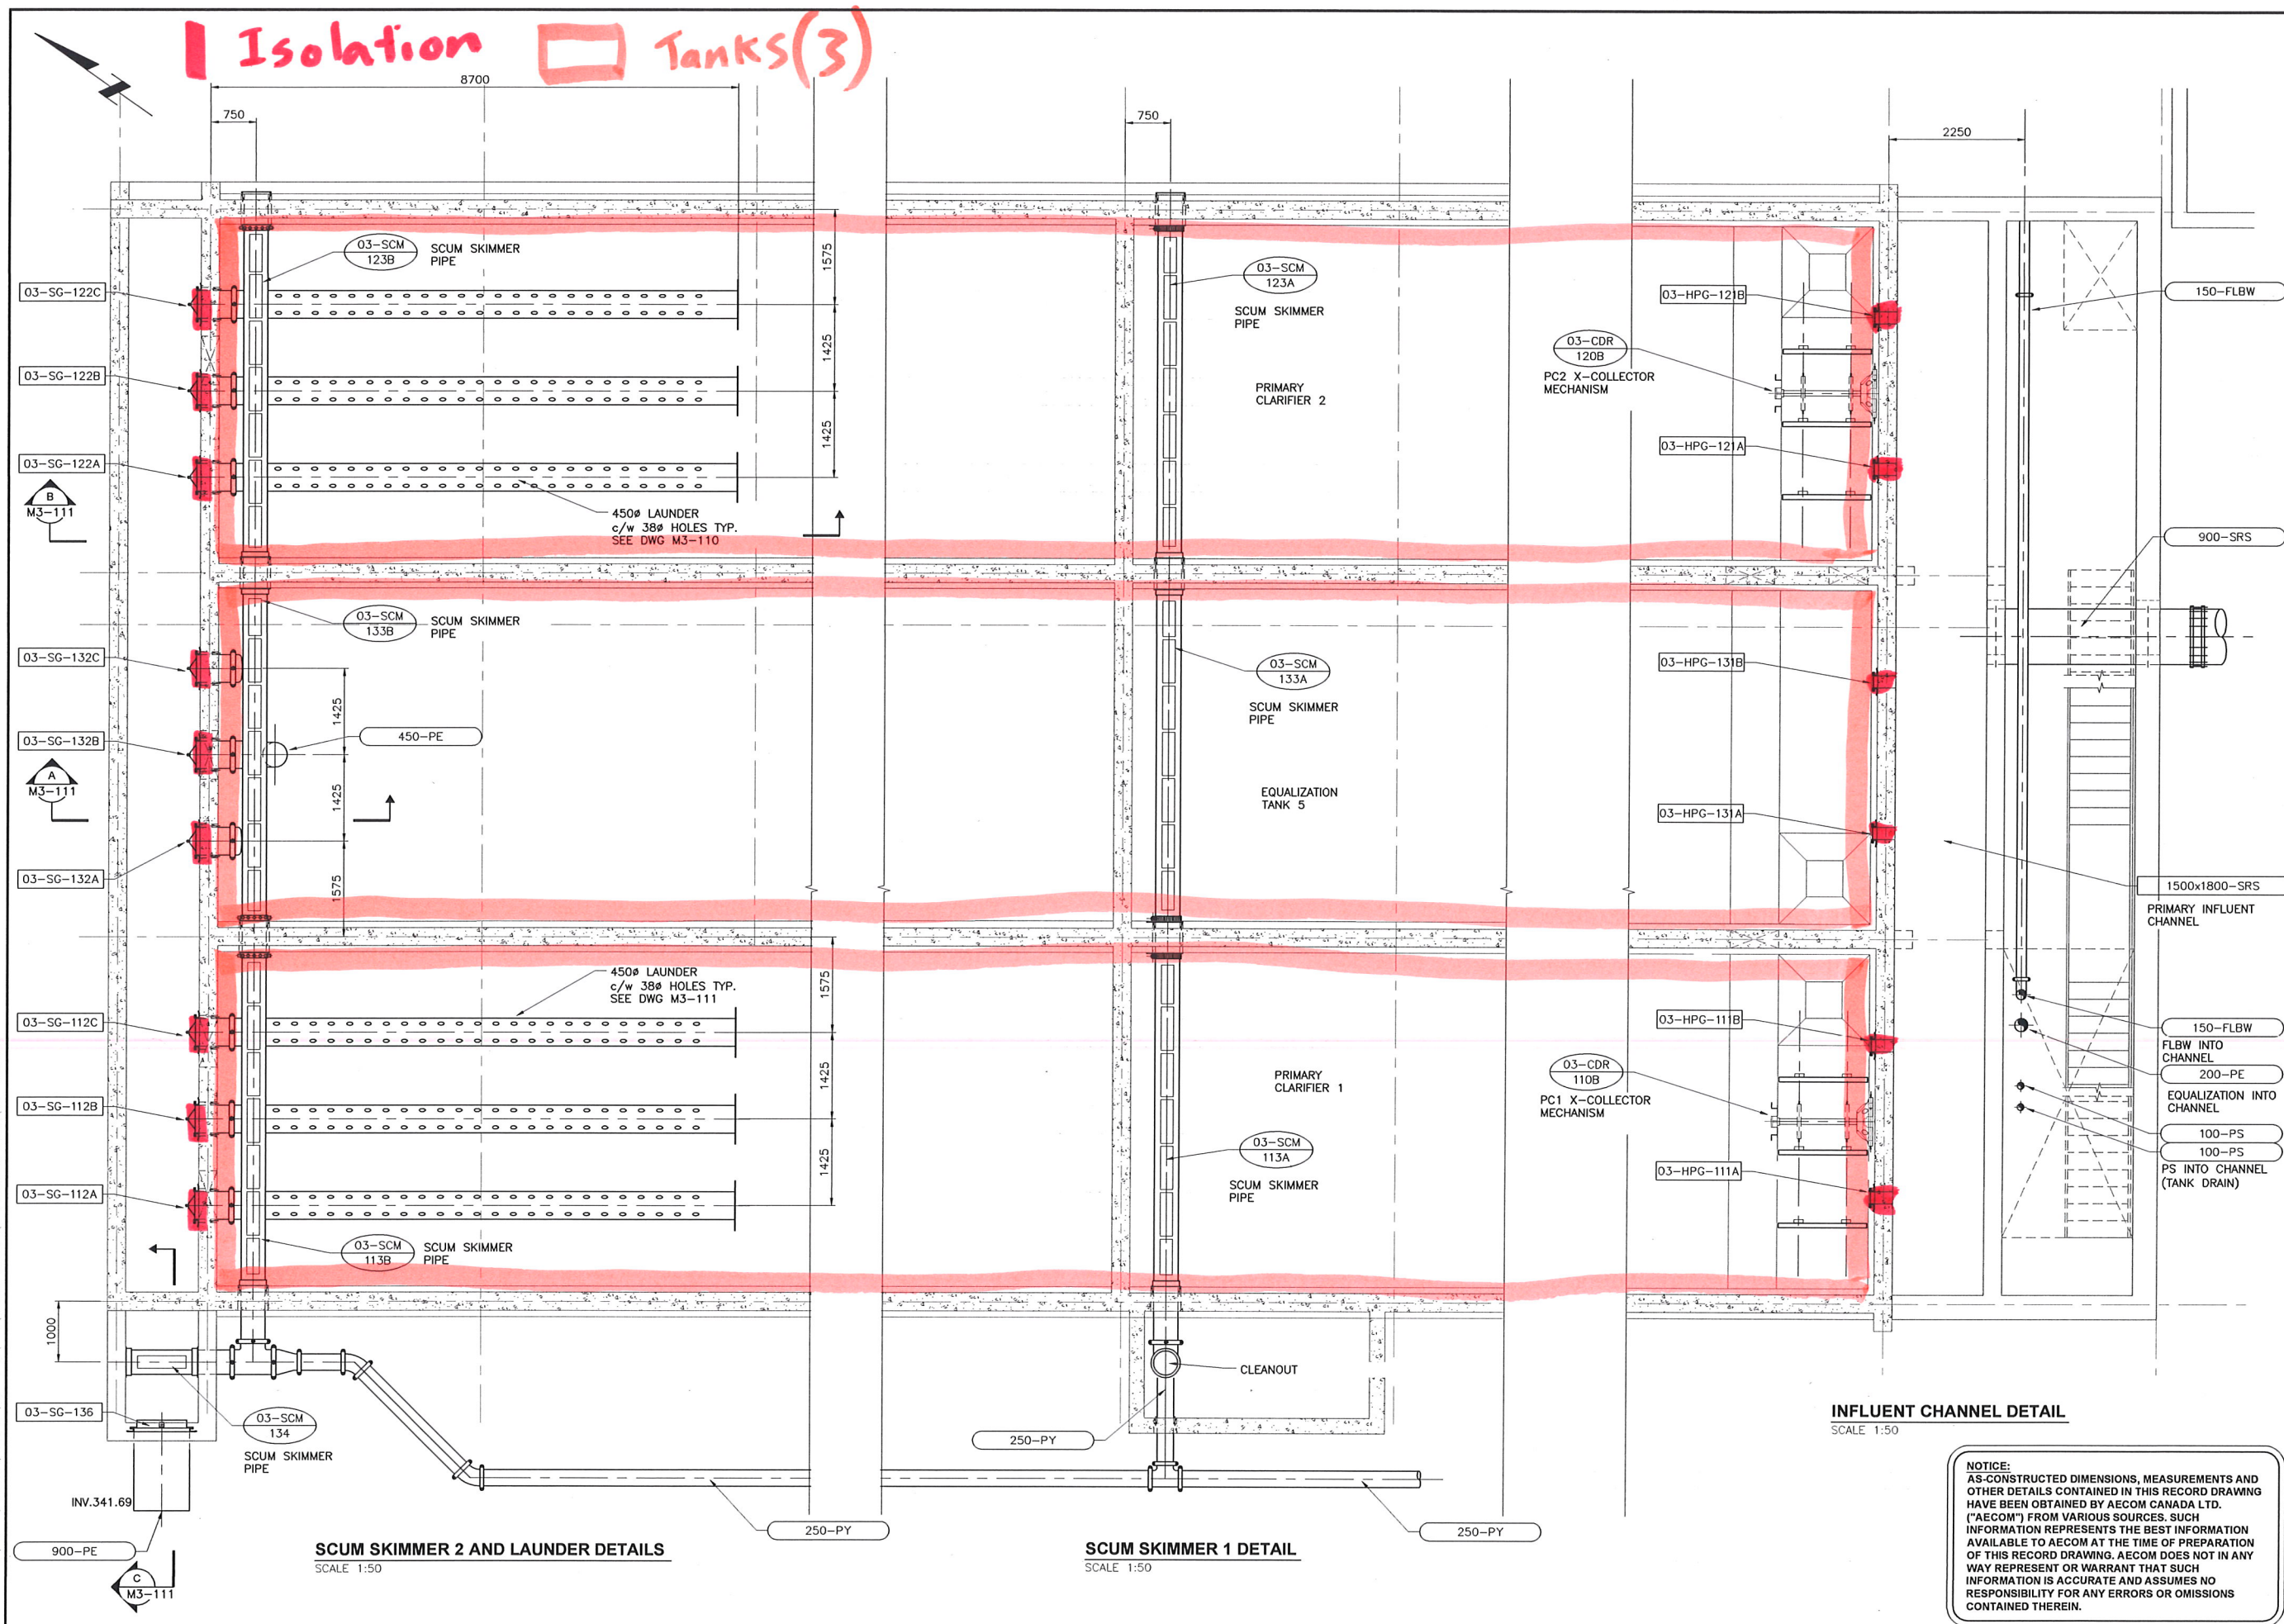

CITY OF PENTICTON AWWTP UPGRADE PENTICTON, B.C.		PROJECT START DATE (M/Y/Y) APRIL 2008	
PROCESS MECHANICAL PRIMARY CLARIFIERS AND EQUALIZATION LOWER LEVEL DETAILS		PROJECT NO. 102949	
		FILENAME M3-106.dwg	
		SHEET NO.	
		DRAWING NO. M3-106	
PREPARED FOR: THE CITY OF Penticton		RECORD DRAWING ISSUED FOR CONSTRUCTION	
AECOM Suite 201, 3275 LAKESHORE ROAD, KELOWNA, BC, CANADA V1W 3S9 250-762-3727		ISSUED FOR TENDER	
PREPARED BY: KJW DES BY: PG CHK BY: LN APP BY: KM		REV 0 1 2	
		DESCRIPTION	
		DATE (Y/M/D)	
		CJM KJW PTL KM KJW KM KJW KM	
		2013/08/09 2009/08/21 2009/05/25	

Plotted By: millercj
Plot File Date Created: Aug/08/2013 10:59 AM
Layout-Sheet Name: M3-104
Filename: L:\WORK\1102000\102949\02A-CAD\WAT\DETAIL DESIGN\6-PROCESS MECH\M3-104.DWG

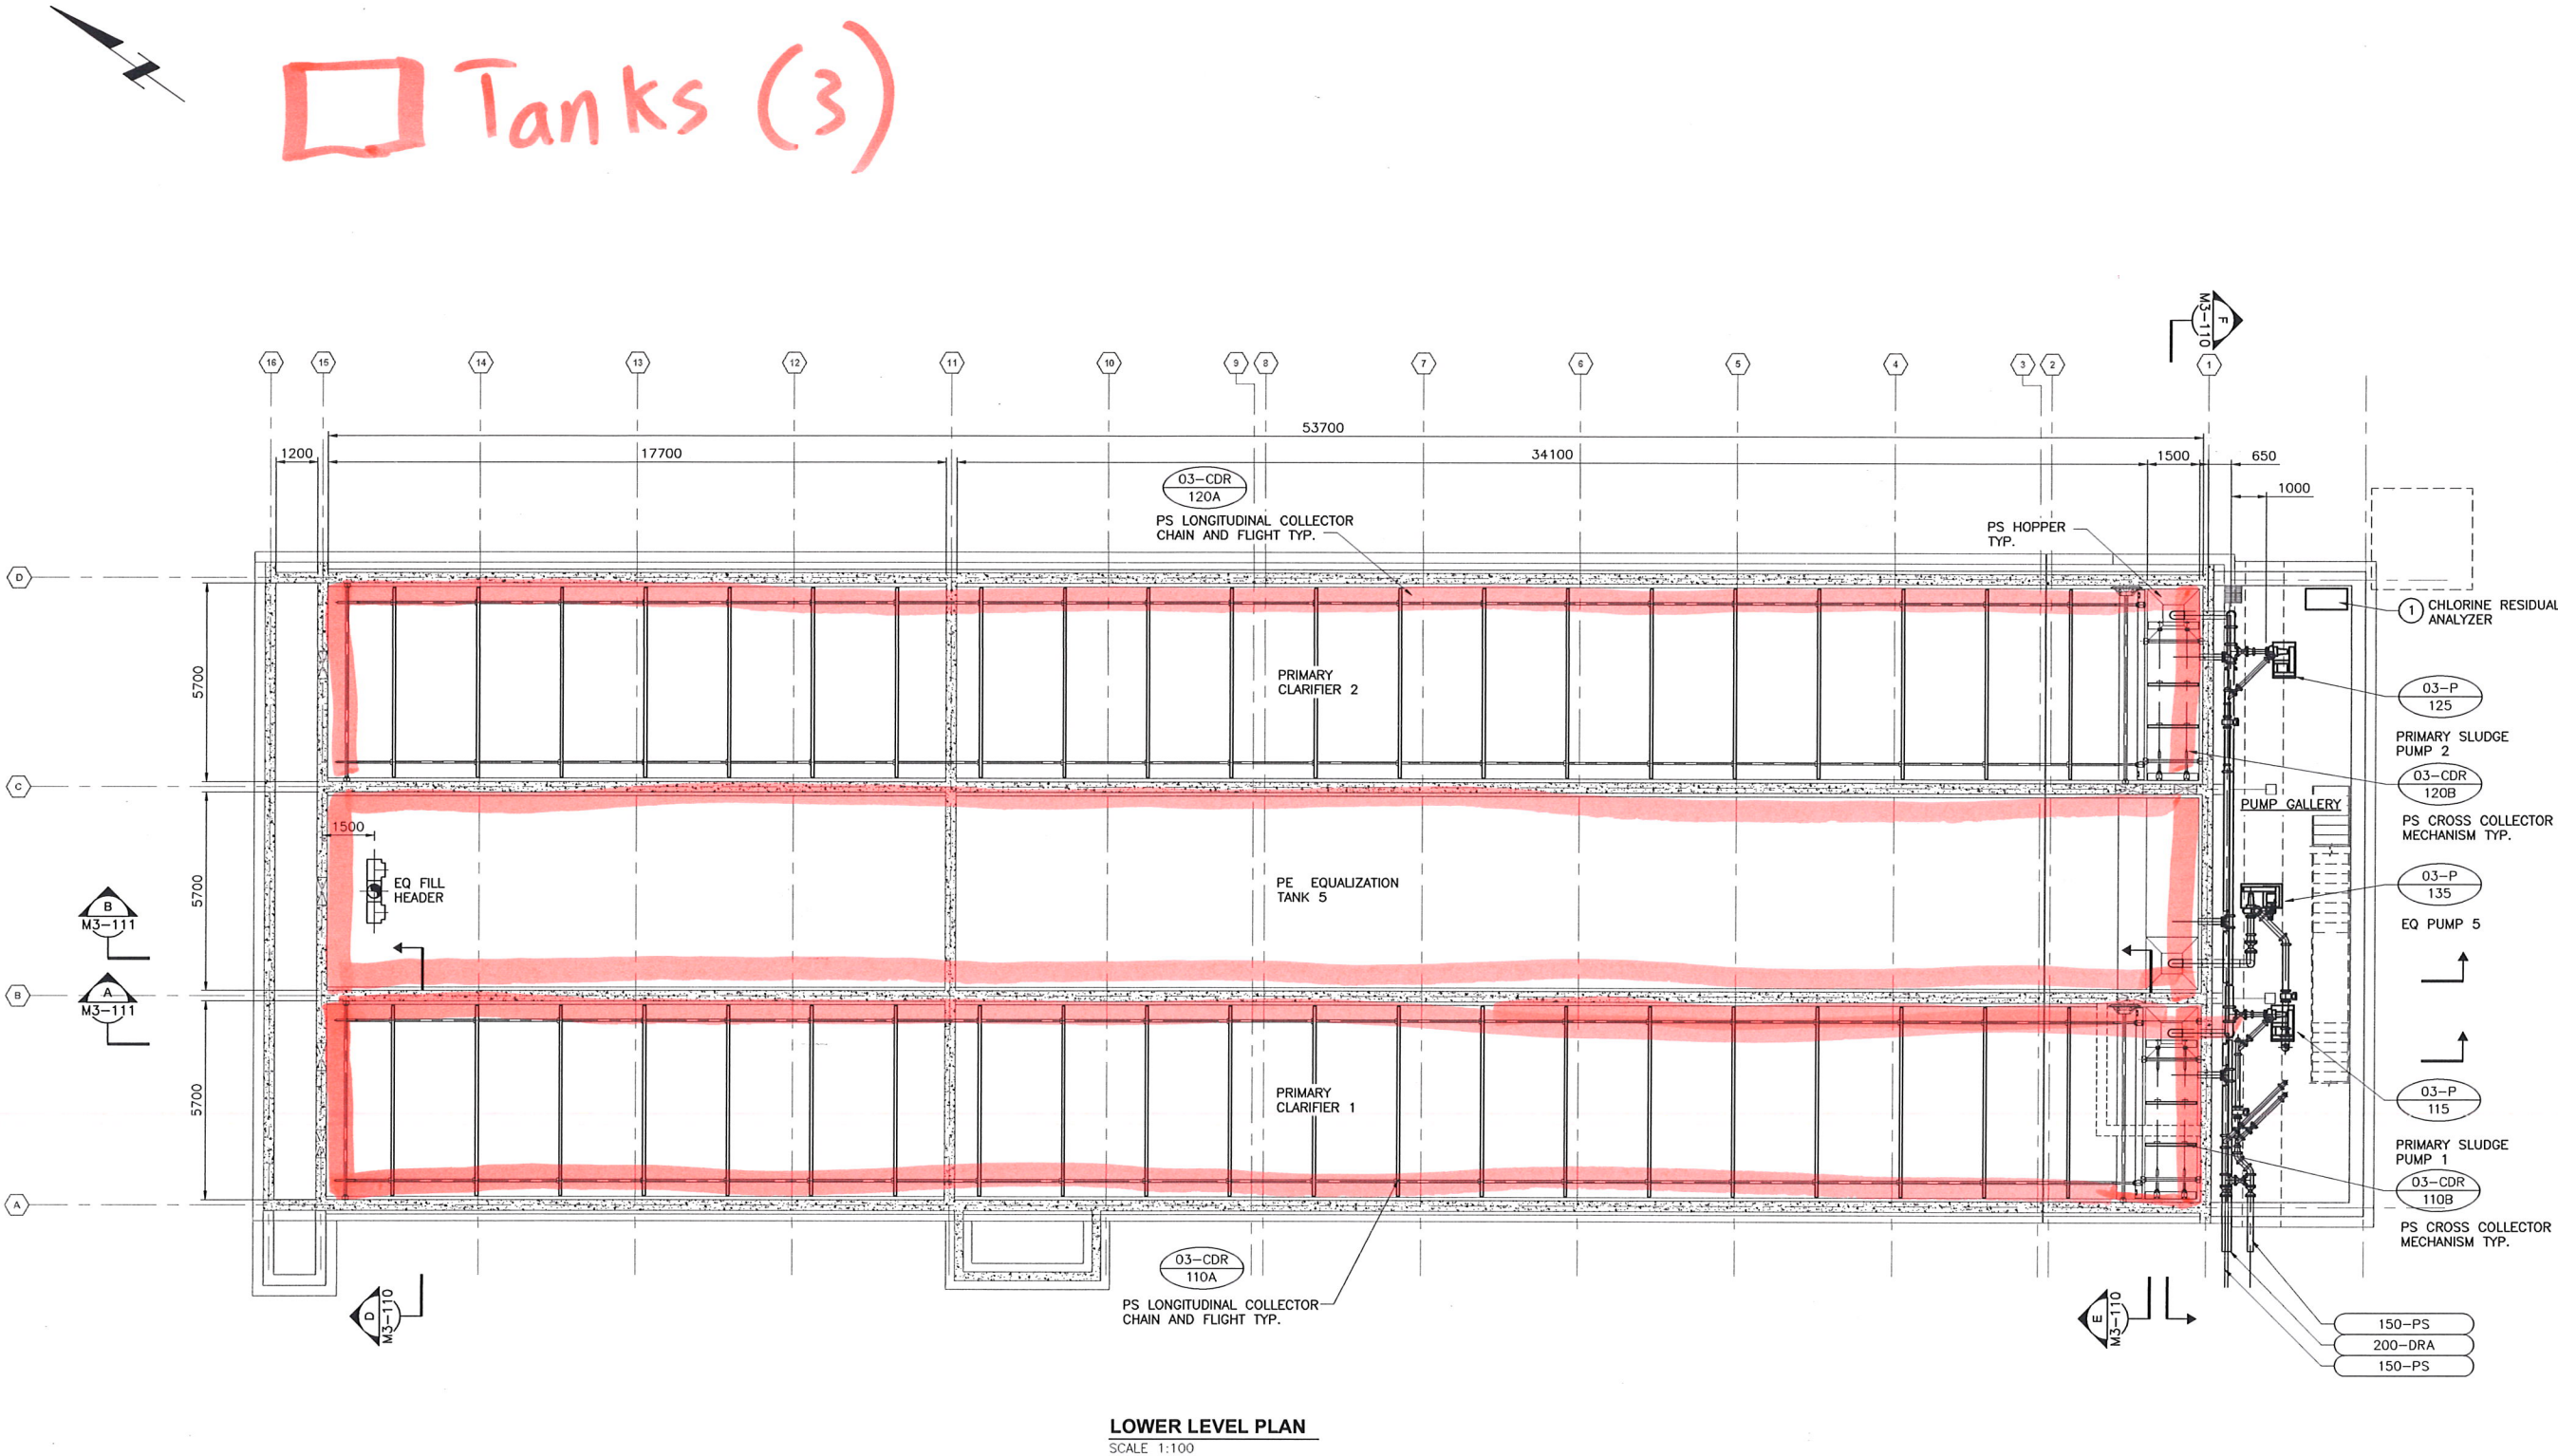

LOWER LEVEL PLAN
SCALE 1:100

KEY NOTES

1. INSTALL CHLORINE RESIDUAL ANALYZER COMPLETE WITH SAMPLE PIPING FROM FLOWMETER MANHOLE AND WASTE TO DRAIN

NOTICE:
AS-CONSTRUCTED DIMENSIONS, MEASUREMENTS AND OTHER DETAILS CONTAINED IN THIS RECORD DRAWING HAVE BEEN OBTAINED BY AECOM CANADA LTD. ("AECOM") FROM VARIOUS SOURCES. SUCH INFORMATION REPRESENTS THE BEST INFORMATION AVAILABLE TO AECOM AT THE TIME OF PREPARATION OF THIS RECORD DRAWING. AECOM DOES NOT IN ANY WAY REPRESENT OR WARRANT THAT SUCH INFORMATION IS ACCURATE AND ASSUMES NO RESPONSIBILITY FOR ANY ERRORS OR OMISSIONS CONTAINED THEREIN.

PROJECT START DATE (M/Y)		APRIL 2008
PROJECT NO.		102949
FILENAME		M3-104.dwg
SHEET NO.		
DRAWING NO.		M3-104
CITY OF PENTICTON AWWTP UPGRADE PENTICTON, B.C.		
PROCESS MECHANICAL PRIMARY CLARIFIERS AND EQUALIZATION GENERAL ARRANGEMENT - LOWER LEVEL		
PREPARED BY: AECOM Suite 201, 3275 LAKESHORE ROAD, KELOWNA, BC, CANADA V1W 3S9 250-762-3727		
THE CITY OF Penticton		
PREPARED FOR:		
DRN BY: KJM		2013/08/09
DES BY: PG		2013/08/09
CHK BY: LN		2013/08/09
APP BY: KM		2013/08/09
REV		0
DESCRIPTION		ISSUED FOR TENDER
RECORD DRAWING		2
REVISED PUMP ARRANGEMENTS		2
ISSUED FOR CONSTRUCTION		1
ISSUED FOR TENDER		0
DATE (Y/M/D)		2009/05/25